
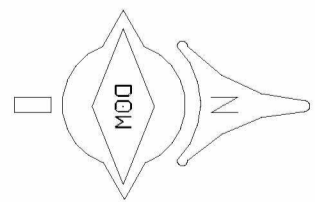


THIS DRAWING IS THE PROPERTY OF THE DOW CHEMICAL COMPANY. ANY REPRODUCTION OR DISTRIBUTION OF THIS DRAWING TO ANY OTHER COMPANY OR INDIVIDUAL WITHOUT THE WRITTEN PERMISSION OF THE DOW CHEMICAL COMPANY IS STRICTLY PROHIBITED. ALL RIGHTS OF INVENTION OR DESIGN ARE RESERVED.

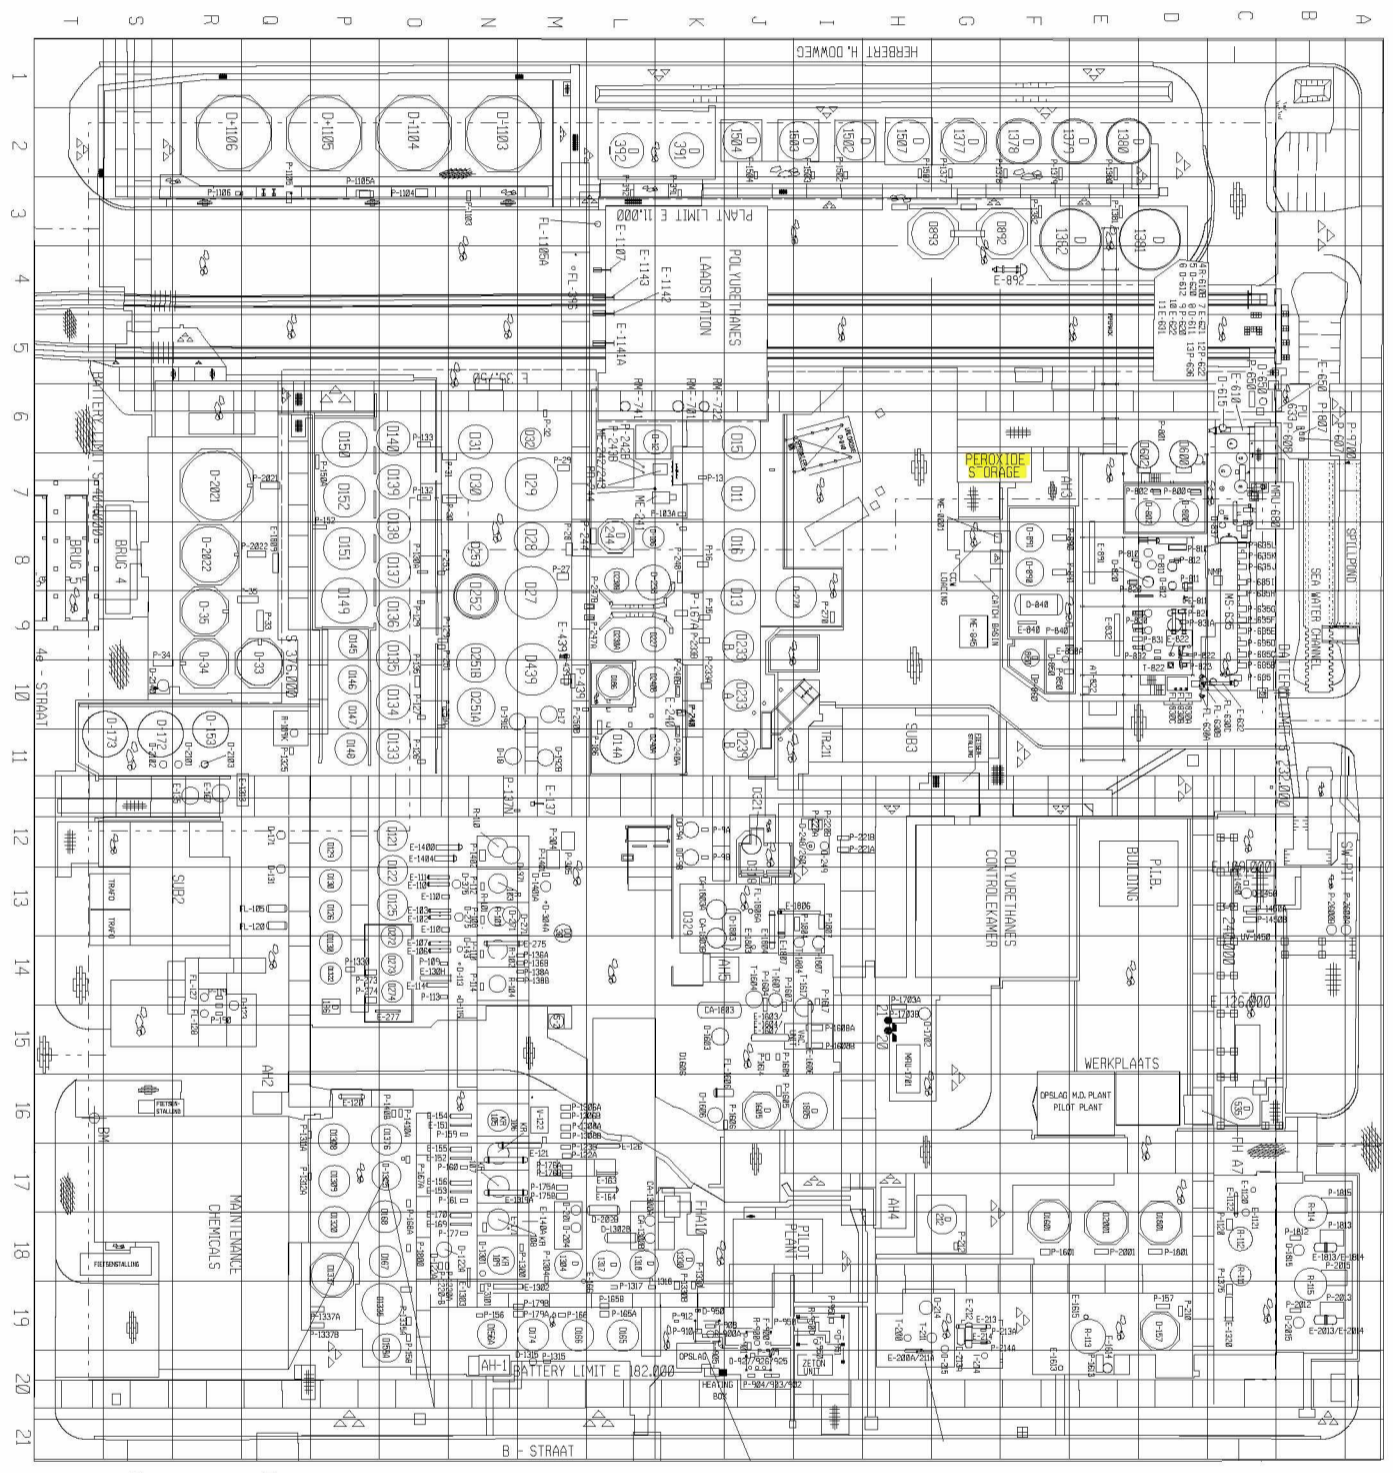

NO.	REVISION	BY	CHK	APP	DATE
A	UPDATED FOR JOB 981419				5/20/00
B	UPDATED FOR PROJ.101402				JAN 11
C	ADDED D-1224				DEC 16
D	UPDATED INFO FOR PROJECT 141414 CPP-11				JUN 17

DRAWING ISSUE RECORD		ISSUE		REV		DATE ISSUED FOR		BY		CHK		APP		DATE	

REVISION	DATE	BY	CHK	APP
03-99				
03-99				
03-99				



ISSUE	NO.	DATE	BY	CHK	APP

DOW BENELUX B.V.
THE NETHERLANDS

TERNEUZEN
POLYURETHANE
POSITIVE STAR
PLOT PLAN MAINTENANCE GRID

PROJECT NUMBER 101402
SCALE 1:5000
PRINTED B01-00020-0131
REV 0

INSTRUCTIONS
PLN

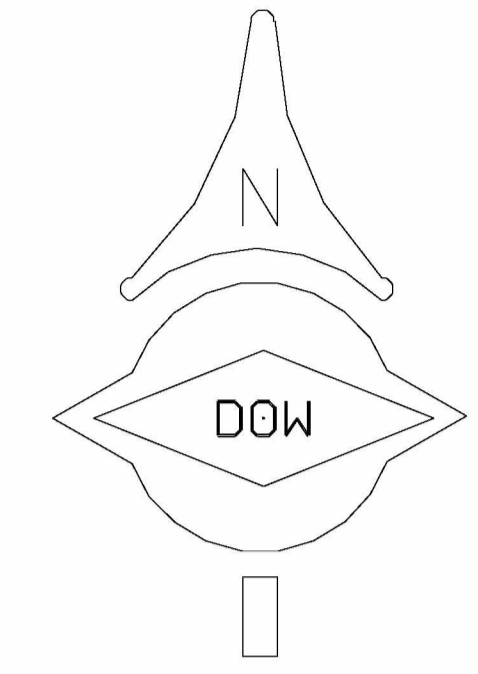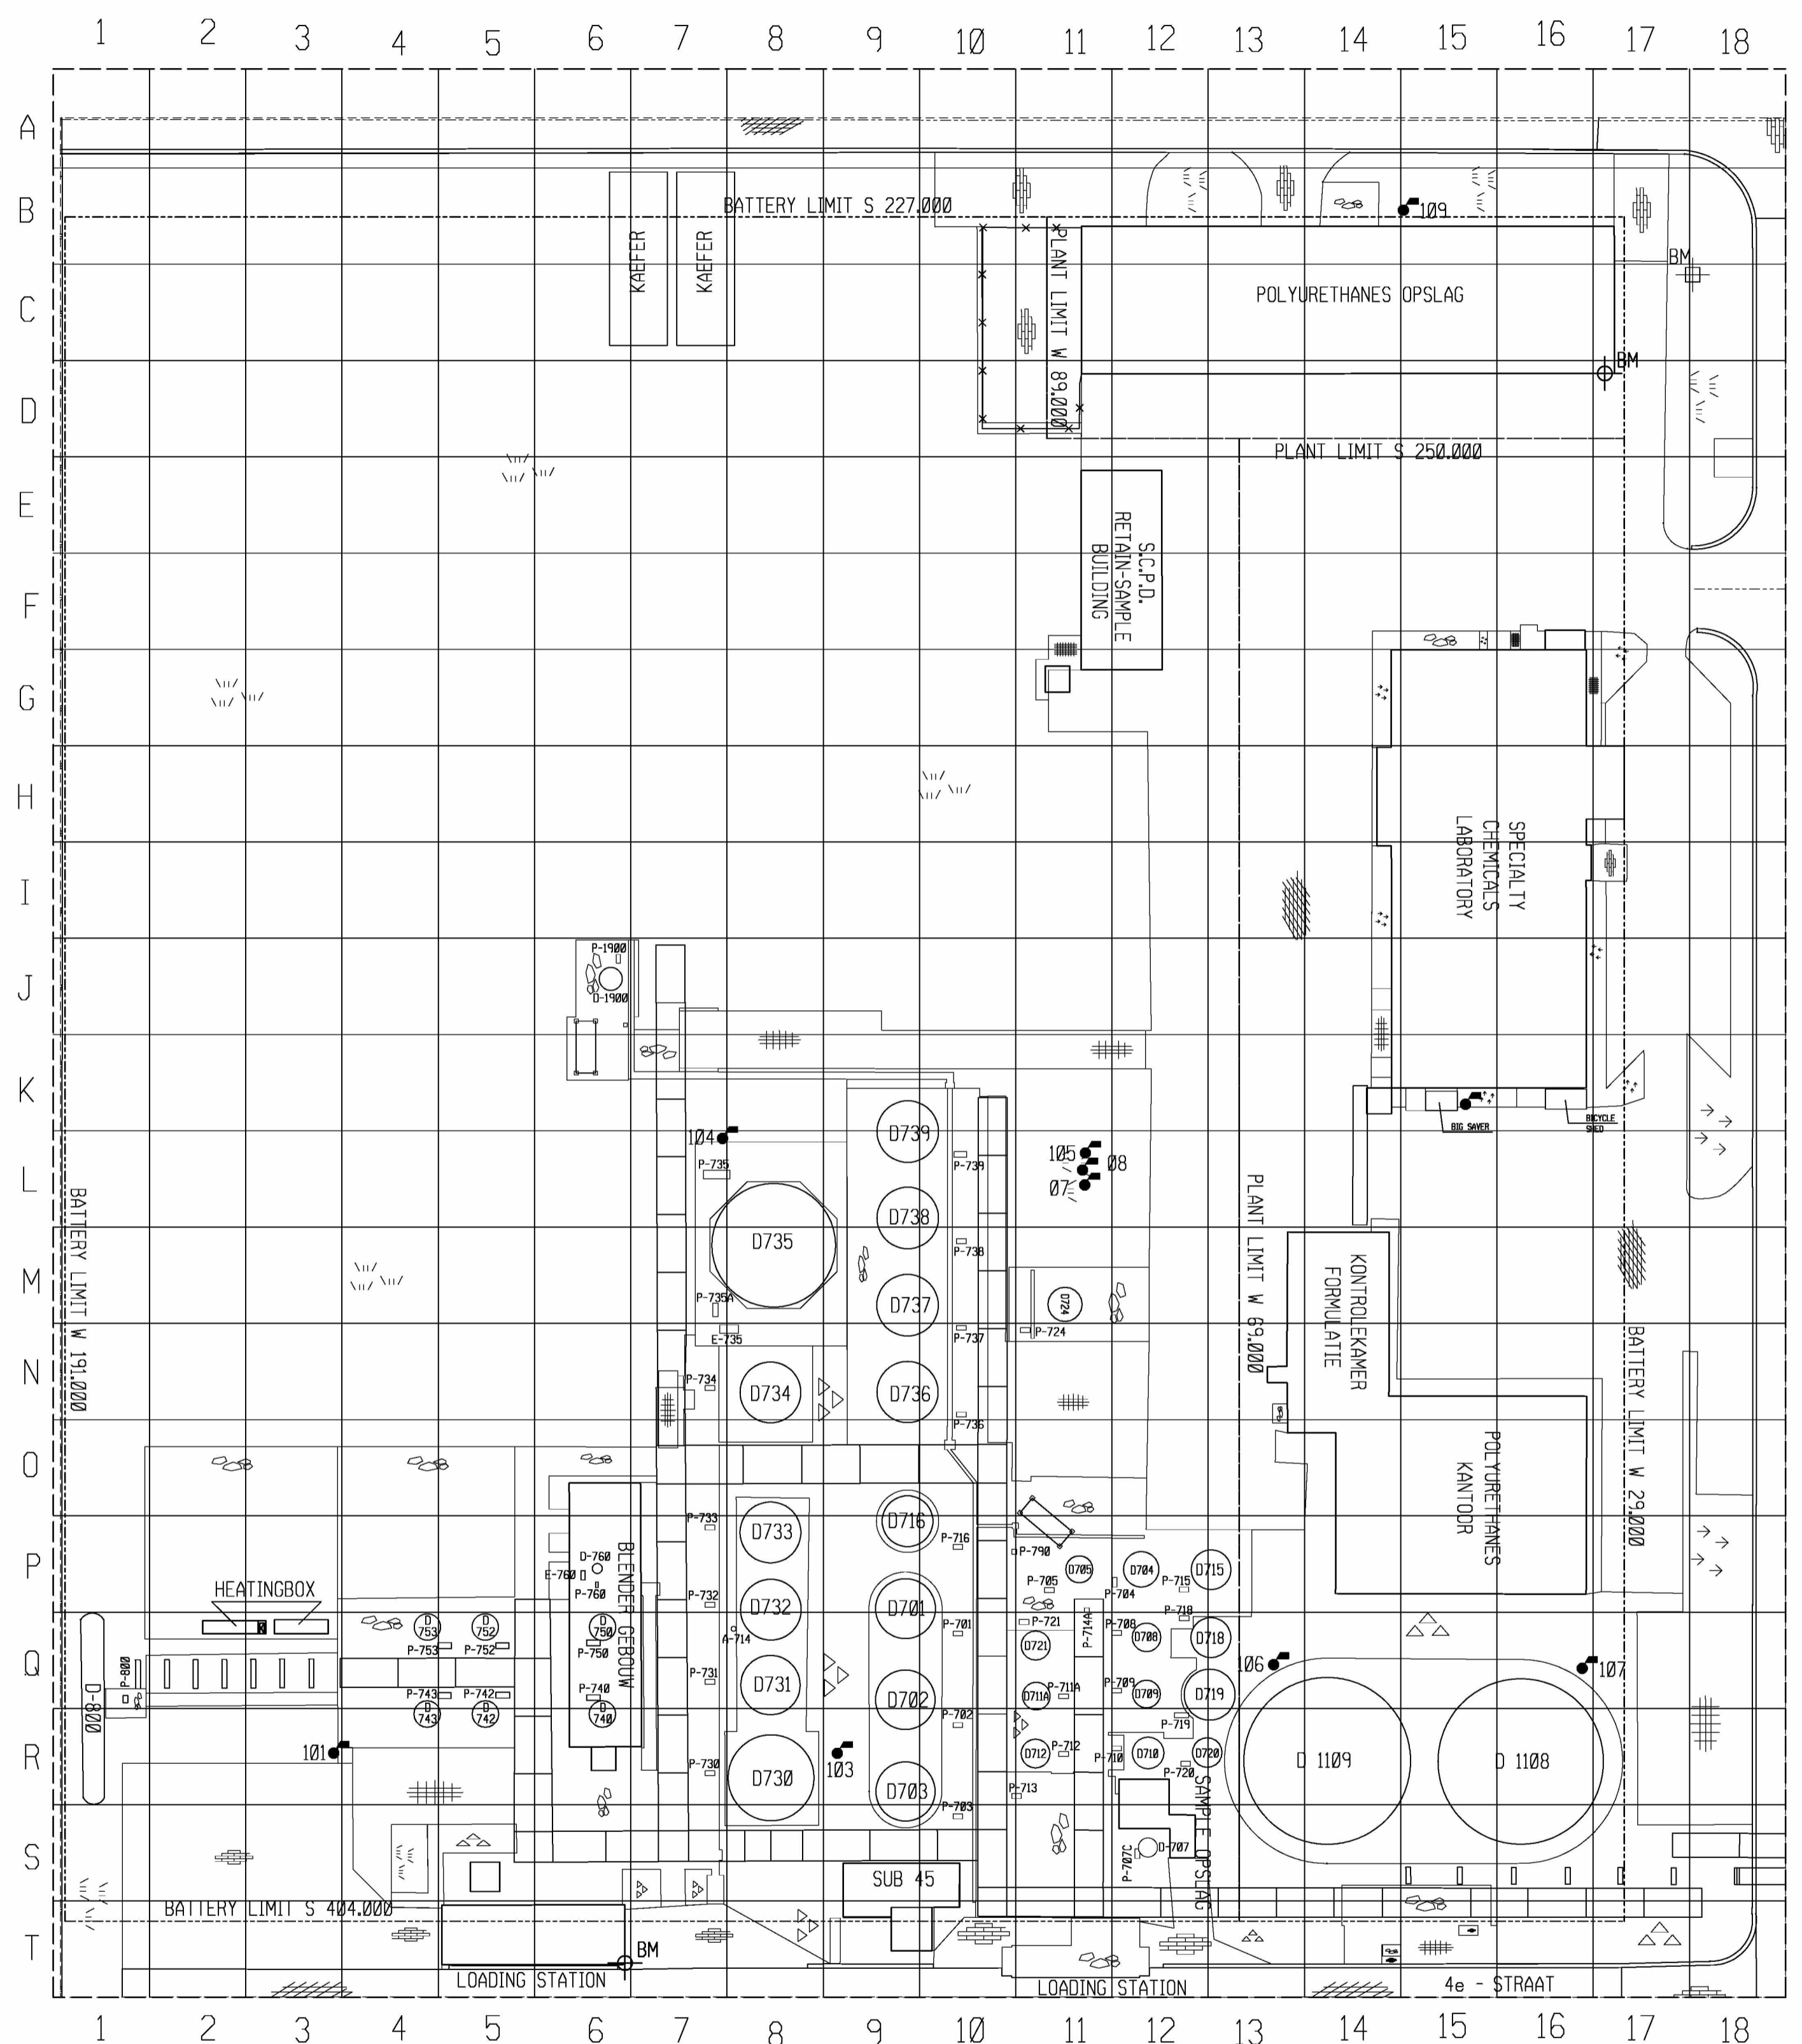

REV. MARK	REVISION	BY	CHK	APP	DATE	REV. MARK	REVISION	BY	CHK	APP	DATE
A	CHANGED DWG.NR.B01-32017-0221 TO B01-00020-0221	VDV			APR.10						
B	UPDATED FOR PROJ.101402	NH			JAN.11						

ISSUE NO.	REV	MATERIAL OR JOB SPEC	BID	FAB	CONST	REF

DRAWING ISSUE RECORD						
DESIGNED	DATE	STATUS	PLANT NO.	DESIGNED	DATE	STATUS
AS-BUILT	0221	04-01	0221			
DRAWN		04-01				
CHECKED						
APPROVED						
PRJ. ENGR.						
PRJ. MGR.						

PROJECT NUMBER	SCALE	FORMULATION	REV
101402	1:500	B01-00020-0221	B

THE DOW CHEMICAL COMPANY

DOW BENELUX N.V. TERNEUZEN 0221


FORMULATION

POSITIE STAR *
PLOT PLAN MAINTENANCE GRID


INSTRUCTIONS 4

A B C D E F G H J

1
2
3
4
5
6
7
8
9
10

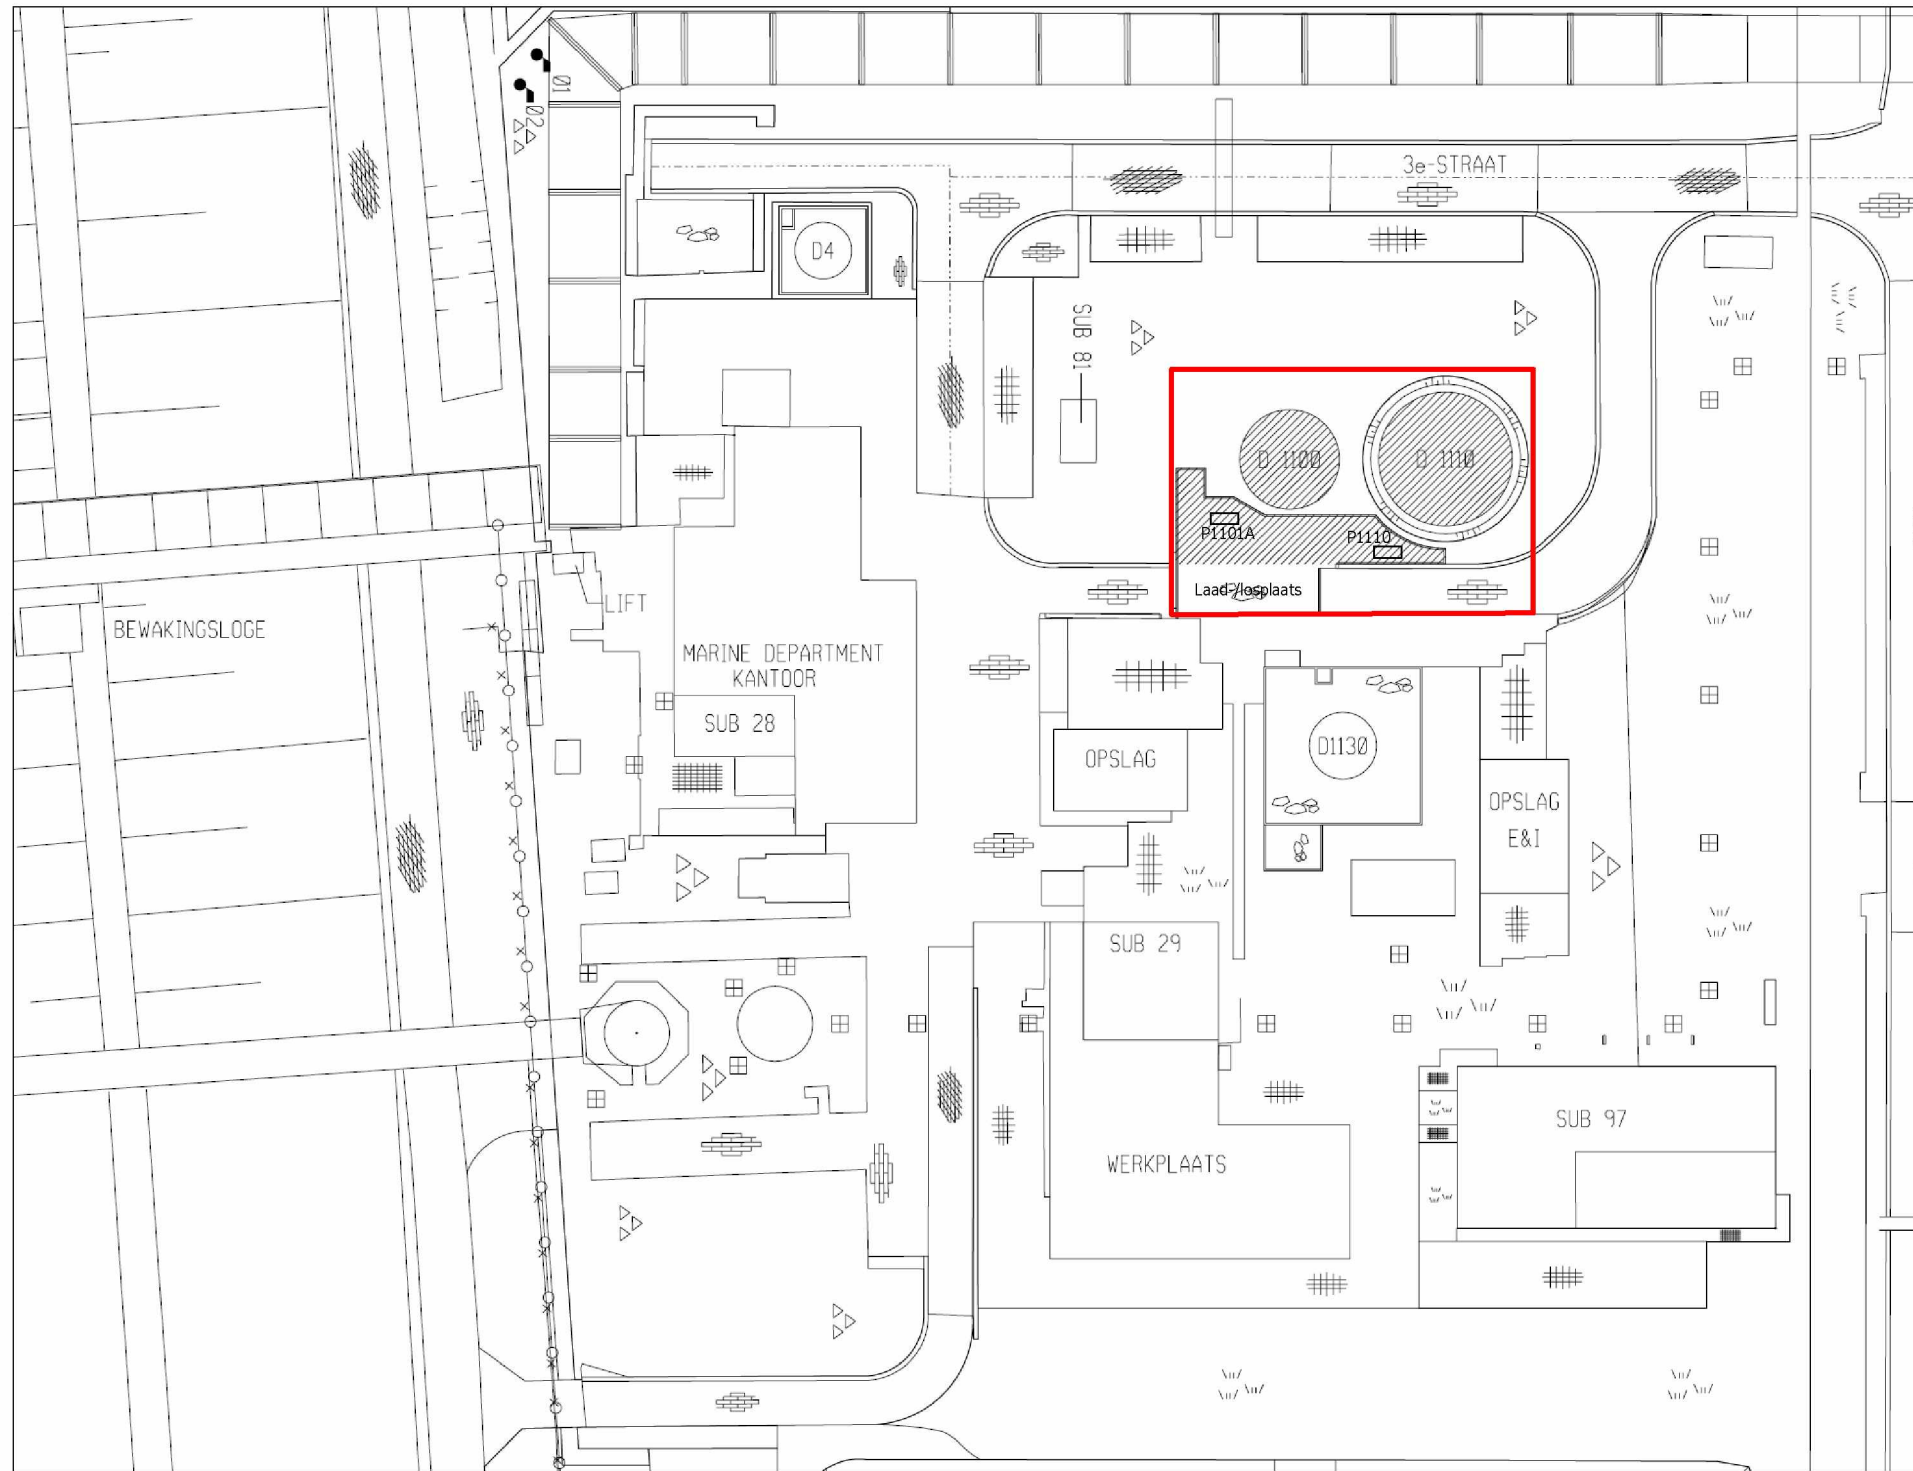




- 1 OPSLAG BULKVLOEISTOFFEN
- 2 OVERSLAG EN INTERN TRANSPORT BULKVLOEISTOFFEN
- 3 OPSLAG EN VERLADING STORT EN STUKGOED
- 4 PROCES ACTIVITEIT / BEWERKINGEN
- 5 OVERIGE ACTIVITEITEN

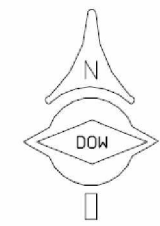

B2-10300-0722

REV. NR.	REVISION	BY	CHK	APP	DATE	REV. NR.	REVISION	BY	CHK	APP	DATE	DESIGNED	DATE	STATUS	PLANT NO.
A	INVENTARISATIE OPGESTELD DOOR												11/2004	AS-BUILT	0722
													11/2004	P.E. REAL	
													11/2004		

TERNEUZEN		DOW BENELUX B.V.		THE NETHERLANDS	
MARINE DEPARTMENT				0722	
MARINE DEP. MPRTD AREA					
BODEMRISICO BEOORDELING VORANOL					
WISNUMMER	SCALE	B2-10300-0722-VDV		REV	A
10628351	1:333 1/3				

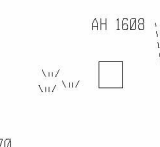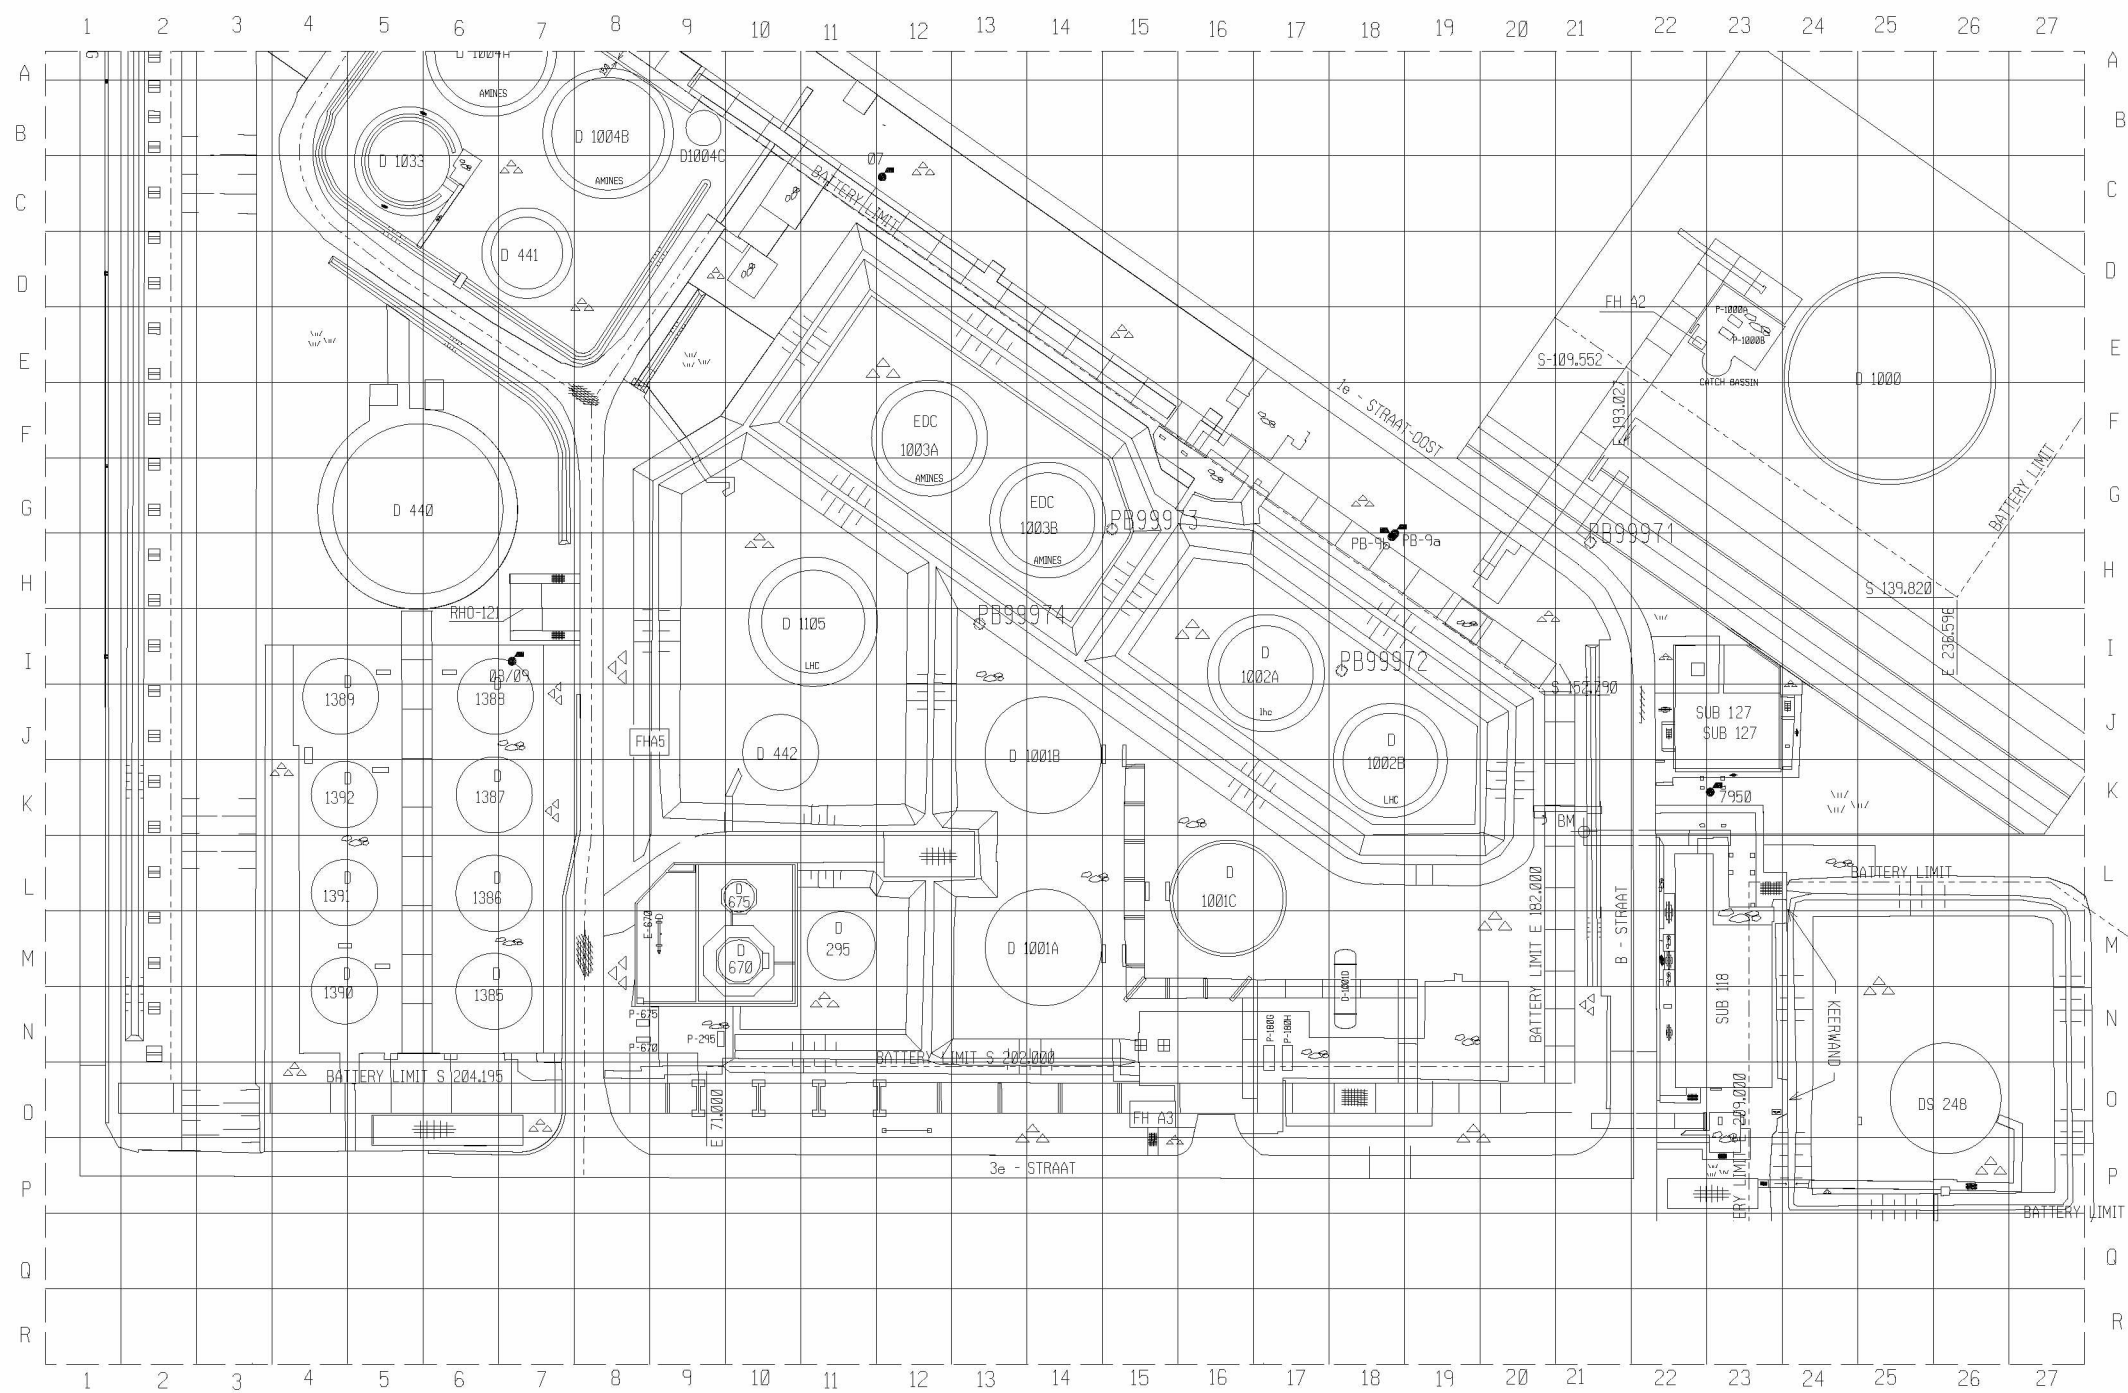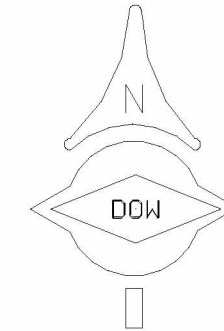

REVISION		BY	CHK	APP	DATE	REV. MARK	REVISION		BY	CHK	APP	DATE	DRAWING ISSUE RECORD			DESIGNED	03-99	STATUS	PLANT NO.	DOW BENELUX B.V. TERNEUZEN THE NETHERLANDS POLYURETHANE 0121 POSITIE STAR * PLOT PLAN MAINTENANCE GRID PROJECT NUMBER 101402 SCALE 1:500 B01-00020-0121	REV
-	NEW DWG.FOR PROJ.101402	NH			JAN.2011											03-99	AS-BUILT	55A	0121		
ISSUE NO.	REV	MATERIAL OR JOB SPEC	BID	FAB	CONST	REF	DATE ISSUED FOR			PROJ.MGR.									4		